




ELECTRICAL CUPBOARD
DISTRIBUTION BOARD AND BMS
CONTROLLER IN EACH DEMISE

General Arrangement Legend

- Partitions - Solid**
- Existing structure
 - Internal partition
- T1 Office Partitions**
30MINS FR
70mm Gyproframe 70 S 50 'C' studs
Centres 600mm
Insulation: 25mm Isover APR (APR1200)
Linings: 1 x 15mm Gyproc Soundbloc to each side
Acoustic rating: 47dB
Thickness: 102mm (before finishes)
Maximum height: 3.8m
RAF TO SLAB
NOTE: Fire barrier within RAF zone.
- T2 Tea Point Partitions**
30MINS FR
70mm Gyproframe 70 S 50 'C' studs
Centres 600mm
Insulation: 50mm Isover APR (APR1200)
Linings: 2 x 15mm Gyproc Soundbloc to each side
Acoustic rating: 56dB
Thickness: 132mm (before finishes)
Maximum height: 4.0m
RAF TO SLAB
NOTE: Fire barrier within RAF zone.
- T3 Meeting Room Partitions**
70mm Gyproframe 70 S 50 'C' studs
Centres 600mm
Insulation: 50mm Isover APR (APR1200)
Linings: 2 x 15mm Gyproc Soundbloc to each side
Acoustic rating: 56dB
Thickness: 132mm (before finishes)
Maximum height: 4.0m
RAF TO CEILING (With F-Trim)
NOTE: An acoustic barrier within RAF and ceiling zone.
- T4 Mechanical Boiling**
70mm Gyproframe 70 S 50 'C' studs
Centres 600mm
Linings: 1 x 15mm Gyproc Soundbloc to one side
Thickness: 100mm (before finishes)
Maximum height: 3.8m
RAF TO 100MM ABOVE CEILING
NOTE: CLS stud boxing to 830mm high underneath window
- T5 Lift Lobby Toilets**
120MINS FR
48 mm Gyproframe 48 S 50 'C' studs
Centres 600mm
Thickness: 100mm (before finishes)
Maximum height: 3.4m
RAF TO CEILING WITH FIRE BATT ABOVE / BELOW AS NECESSARY
Note: Typical ceiling void 640mm / Floor void 110mm
- Partitions - Glazed**
- Curtain walling
 - Crittall style single glazed silicon glass
 - Fusion Fineline 54 in RAL9010

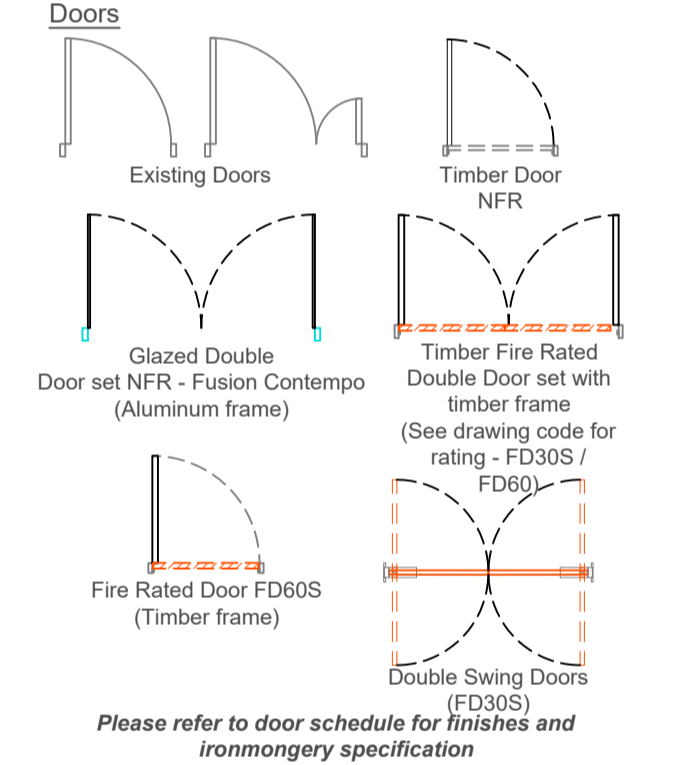

Room Codes:
RG-01 Room Number

Rev.	Description	Drawn	Checked	Date
Drawing Status: AS BUILT				
CONCEPT - APPROVAL - CONTRACT - CONSTRUCTION - AS BUILT				
MARIS THE WORKPLACE DESIGN EXPERTS				
M4, The Millennium Centre, Crosby Way, Farnham Surrey GU9 7XX		+44 (0)1252 745200 Farnham@maris-interiors.co.uk www.fsi-group.co.uk		
Client:		Site Address:		
BA PENSIONS		South Quay Building 77 Marsh Wall London E14 9SH		
Floor & Drawing: 6th Floor General Arrangement				
Drawing Number: 28616 - 6th - GA - AB				
Project Number	Floor Level	Drawing Code	Revision	
Produced By:				HC
Creation Date:				23/11/21
Scale:	SCALE 1:100@ A1			
Drawing Notes: Figured dimensions only are to be taken from this drawing - DO NOT SCALE. Contractors must verify all dimensions prior to construction and any discrepancies are to be reported. Design © Maris				